

The area of everything within the fence - 217,000 square feet.

The area of everything under a roof - 24,000 square feet.


The area of the offices - 4,350 square feet.

The area of the offices, labs, main building, MCC, and Dryer room is 17,800 square feet.

The area Waste Treatment is 1,850 square feet.



- ADDED VALUE ITEMS
- 8'x15' STORM SHELTER
  - HALON FIRE SUPPRESSION FOR ONE LAB AREA
  - ONE RAIL SPUR
  - GROUNDING GRID

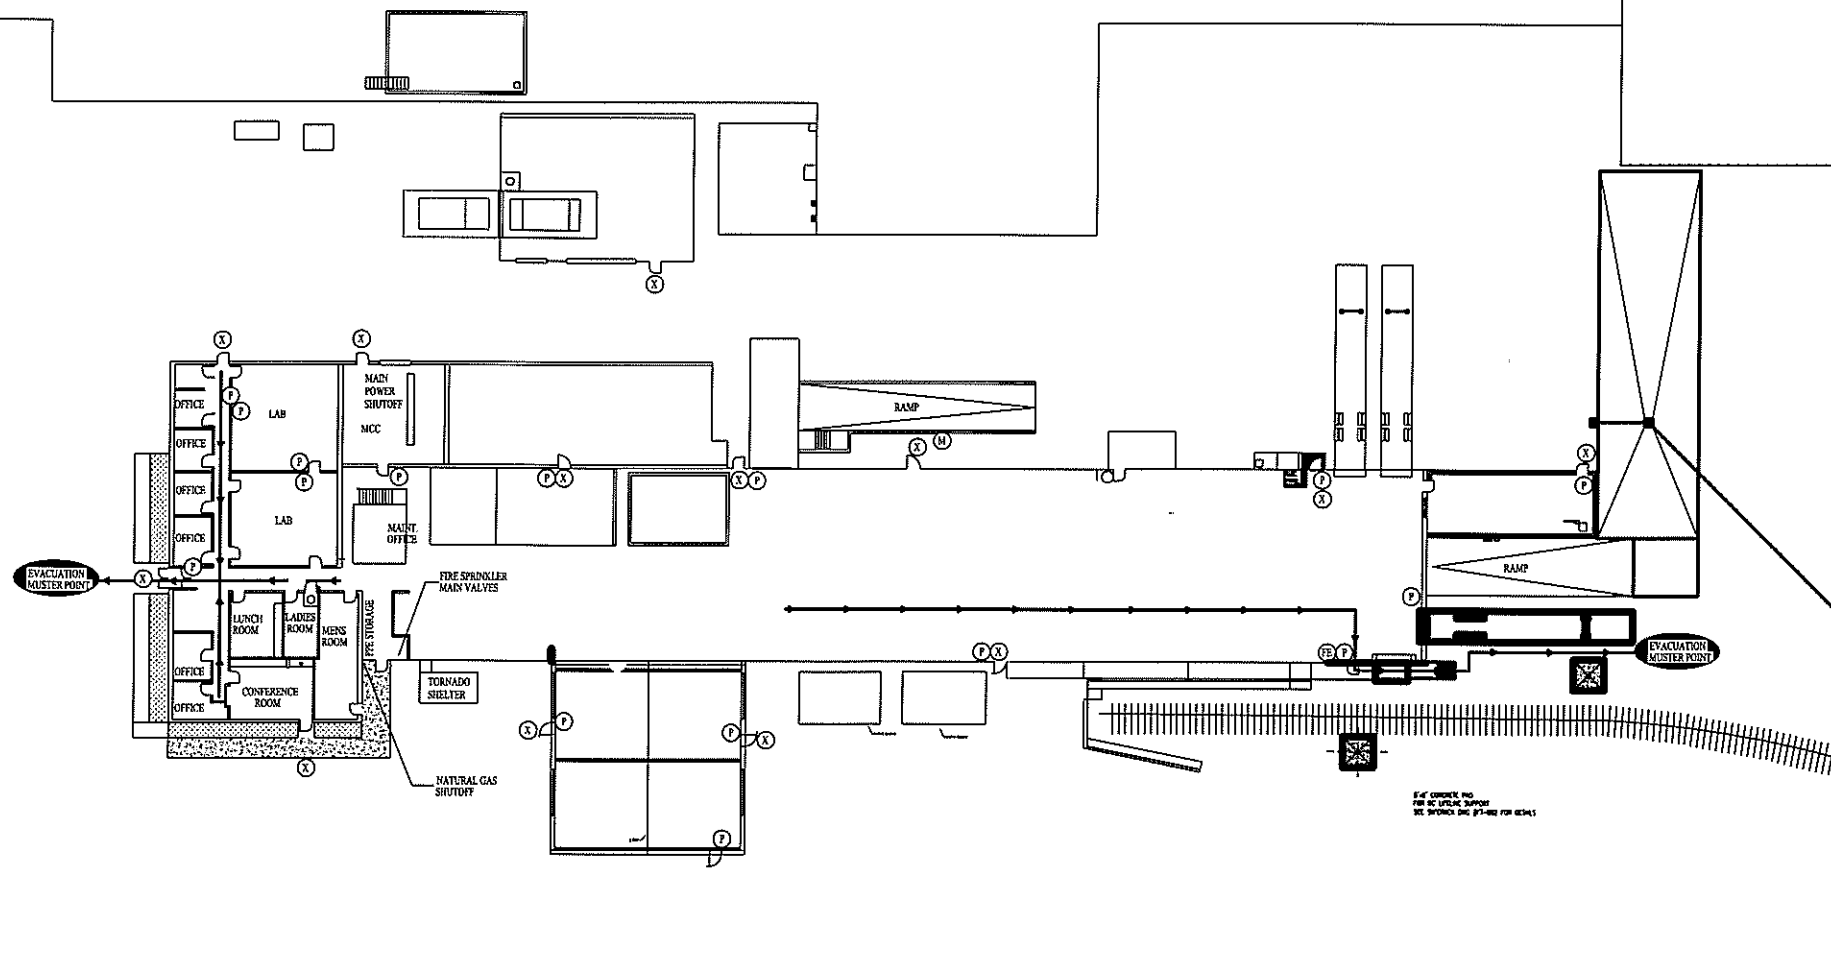

FLAG POLE  
WATER MAIN SHUTOFF

- EVACUATION ROUTE
- MUSTER POINT
- EXIT
- FIRE PULL

SEE COMMENTS FOR  
FOR SC SYSTEM SUPPORT  
SEE DRAWING DWG 97-002 FOR DETAILS

REVISIONS					REVISIONS				
ZONE	REV	DESCRIPTION	DATE	APPROVED	ZONE	REV	DESCRIPTION	DATE	APPROVED
ALL	0	ASBUILT	12/21/04						
ALL	1	ADDED EVAC ROUTES TO SAFETY LAYER	02/26/05						
AS/DS	2	ADDED VAC SYS AND NEW KOH TANK	04/11/06						
	3	ADDED HF RC UNLOADING AND FIBER DRUM DOCK	05/09/07						
D7	4	ADDED SQUARE FOOTAGE OF AREAS	03/11/09	SCW					
ALL	5	REMOVE EQUIPMENT LIST SQ FOOTAGE	5-7-2009	SCW					



**SOLVAY FLUORIDES, LLC**  
3333 RICHMOND AVE.  
HOUSTON, TX 77098

DRAWING TITLE  
**SITE EMERGENCY PLAN**  
NOCOLOK PRODUCTION FACILITY  
CATOOSA, OK

SCALE: NONE DESIGNER: CELERITY3 SHEET: 1 OF 1

